



MD 355 IS ASSUMED TO RUN
IN A NORTH-SOUTH DIRECTION


PROPOSED SIGNAL
HEADS TO BE BAGGED

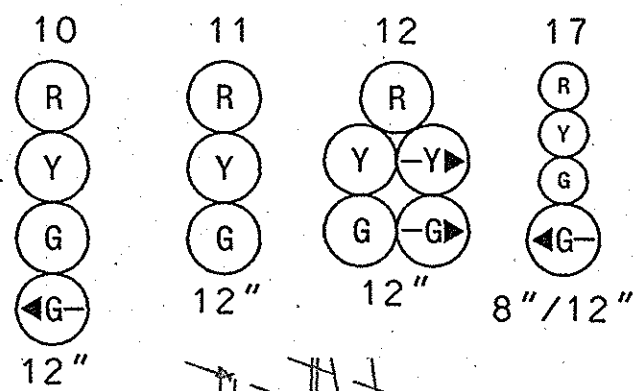


EX. SIGNS TO BE
RELOCATED (SHOWN
AT FINAL LOCATION)

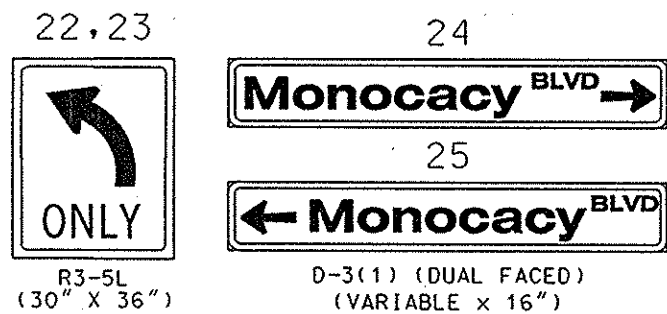


PROPOSED SIGNS
TO BE COVERED

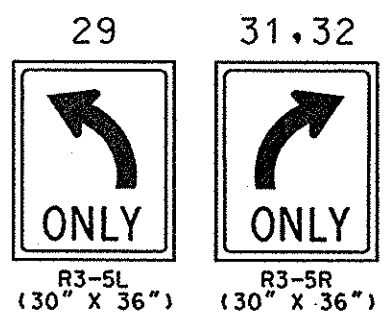

PROPOSED
SIGNS

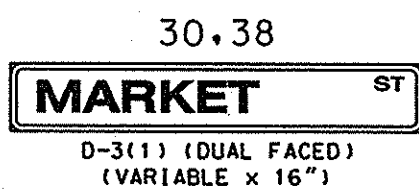


EXISTING
SIGNS TO
REMAIN

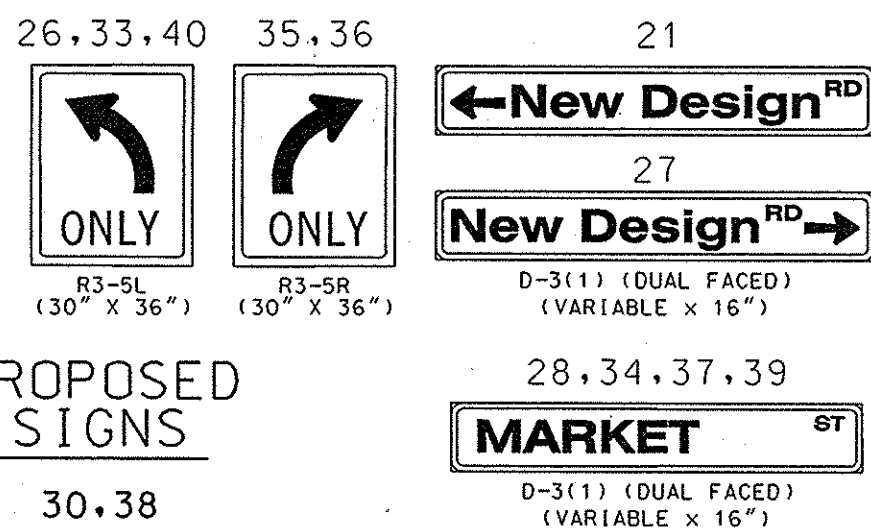


TELEPHONE 19' - 5"
TELEPHONE 24' - 0"
CABLE 24' - 1"
FIBER 26' - 3"
SECONDARY 29' - 10"
PRIMARY 35' - 5"


EXISTING
SIGNAL HEADS
TO REMAIN

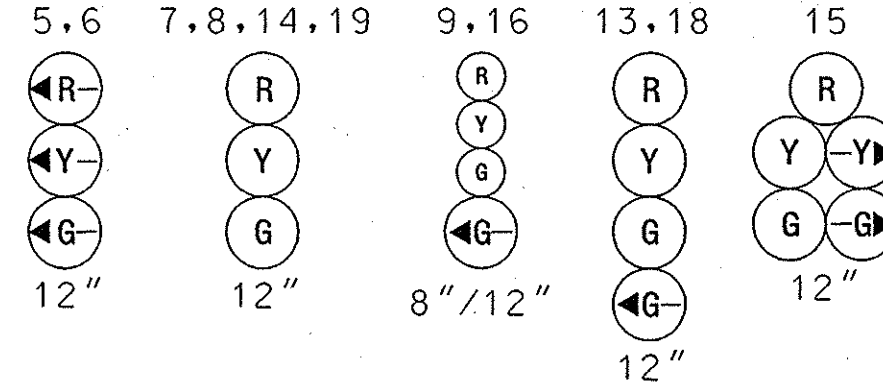

EXISTING SIGNALS
TO BE RELOCATED
(SHOWN AT FINAL
LOCATION)

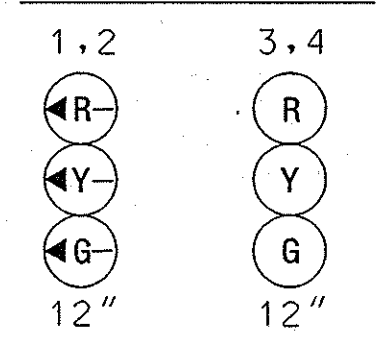


NEMA PHASING

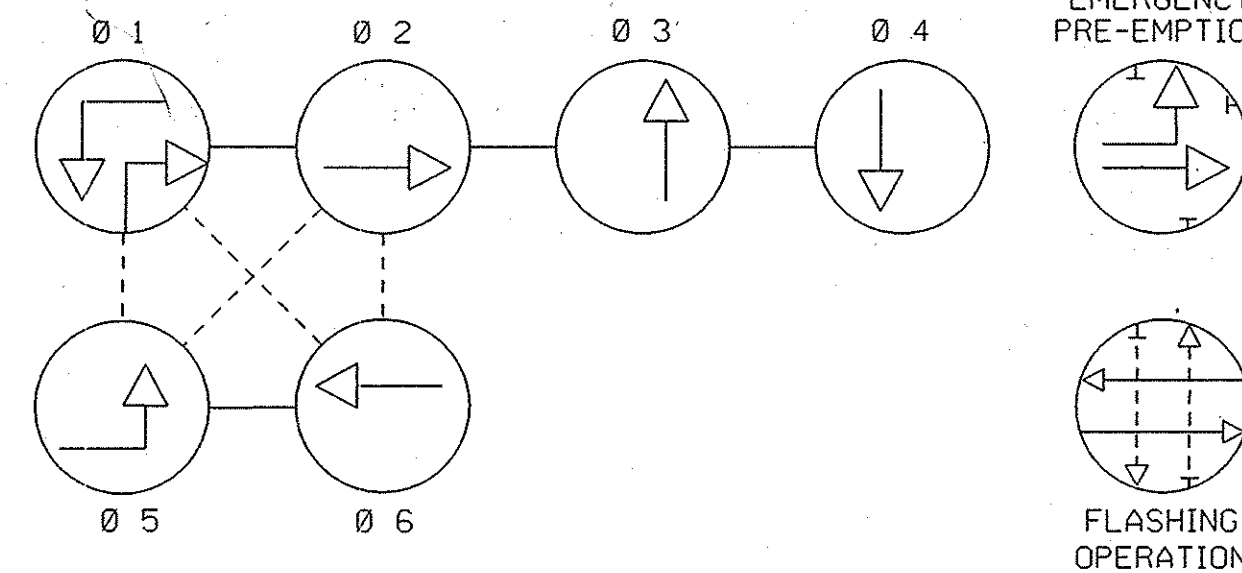


PHASING NOTES:
1. PHASES ASSOCIATED BY A SOLID LINE WILL NOT OPERATE CONCURRENTLY.
2. PHASES ASSOCIATED BY A DASHED LINE WILL OPERATE CONCURRENTLY.

EXISTING VIDEO
DETECTION CAMERA

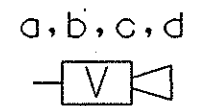

EXISTING
OPTICOM
DETECTOR

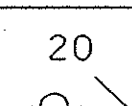

CONSTRUCTION DETAILS

- INSTALL 27 FT. STEEL POLE (POLE SHALL BE ORIENTED FOR FUTURE MAST ARM INSTALLATION FOR THE MD 355 NORTHBOUND APPROACH). (INSTALL 1-2 IN. AND 1-4 IN. SCHEDULE 80, 90 DEGREE POLYVINYL CHLORIDE ELECTRICAL CONDUIT BENDS IN POLE BASE).
- INSTALL 27 FT. STEEL POLE WITH A 70 FT. MAST ARM. TRAFFIC SIGNAL HEADS SIGNS AND 15 FT. STREET LIGHT ARM WITH 250 WATT HIGH PRESSURE SODIUM VAPOR LUMINAIRE. (INSTALL 1-2 IN. AND 1-4 IN. SCHEDULE 80, 90 DEGREE POLYVINYL CHLORIDE ELECTRICAL CONDUIT BENDS IN POLE BASE).
- INSTALL HANDHOLE.
- INSTALL 4 IN. SCHEDULE 80, POLYVINYL CHLORIDE ELECTRICAL CONDUIT (TRENCHED).
- INSTALL 4 IN. SCHEDULE 80, POLYVINYL CHLORIDE ELECTRICAL CONDUIT (BORED).
- INSTALL 3 IN. SCHEDULE 80, POLYVINYL CHLORIDE ELECTRICAL CONDUIT (TRENCHED).
- RELOCATE EXISTING SIGNAL HEADS AND SIGNS ON SPAN WIRE AS NOTED.
- ADJUST VIDEO DETECTION CAMERA(S) TO ENSURE PROPER DETECTION DUE TO SHIFTING OF TRAVEL LANES. ADJUSTING OF VIDEO DETECTION CAMERA WILL NOT BE MEASURED AND PAID BUT WILL BE INCIDENTAL TO THE VIDEO TRAFFIC DETECTION CAMERA UNIT COST.
- INSTALL 24 IN. WHITE REMOVABLE PREFORMED PAVEMENT LINE MARKINGS (STOP LINE).
- USE EXISTING HANDHOLE.
- USE EXISTING CONDUIT.
- USE EXISTING BASE MOUNTED CABINET AND CONTROLLER.


SPECIAL NOTES:

- CONTRACTOR SHALL INSTALL CONDUIT AT SUFFICIENT DEPTH TO AVOID DISTURBANCE DURING ROADWAY CONSTRUCTION. CONDUIT SHALL BE INSTALLED PRIOR TO BEGINNING ROADWAY CONSTRUCTION.
- SUFFICIENT LENGTHS OF SPARE CABLE SHALL BE INSTALLED TO RELOCATE SIGNAL HEADS FOR LATER STAGES.

LEGEND OF UNDERGROUND
AND OVERHEAD UTILITIES

AERIAL CABLE	A
ELECTRICAL	E
TELEPHONE	T
GAS	G
SEWER	SS
STORM DRAIN	SD
WATER	W
CABLE TV	TV

WR&A
Whitman, Reardon
and Associates, LLP
801 South Caroline Street
Baltimore, Maryland 21231
(410) 235-3450

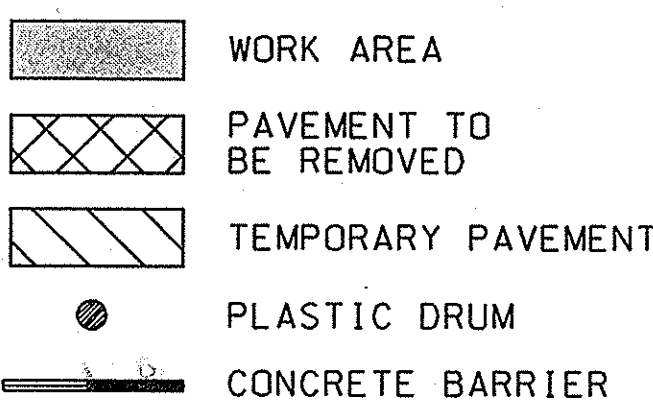

GENERAL NOTES

SHA
RIGHT-OF-WAY

- ALL TRAFFIC SIGNAL FOUNDATIONS SHALL BE INSTALLED AT FINAL SIDEWALK OR CURB GRADE FOR CLOSED SECTIONS. HIGHEST ROADWAY PROFILE GRADE FOR OPEN SECTIONS. TO MEET CLEARANCE AS SPECIFIED IN MD 816.03, MD 818.01, MD 818.02, MD 818.04. THE CONTRACTOR SHALL VERIFY ULTIMATE GRADES PRIOR TO THE INSTALLATION OF ALL SIGNAL EQUIPMENT.
- ALL UNDERGROUND AND OVERHEAD UTILITIES SHOWN ON THESE PLANS ARE SCHEMATIC ONLY AND MAY NOT BE COMPLETE. THE CONTRACTOR SHALL BE RESPONSIBLE FOR NOTIFYING MISS UTILITY PRIOR TO THE CONSTRUCTION SO THAT ALL UTILITIES MAY BE LOCATED IN THE FIELD. IF THE CONTRACTOR PERCEIVES THAT A CONFLICT BETWEEN UTILITIES AND THE TRAFFIC SIGNAL WILL OCCUR, THE CONTRACTOR SHALL NOTIFY THE PROJECT ENGINEER IMMEDIATELY SO THAT THE CONFLICT MAY BE RESOLVED.
- VERIFY PROPOSED GEOMETRICS PRIOR TO INSTALLING SIGNAL EQUIPMENT.
- ALL HANDHOLES SHALL BE INSTALLED AT FINAL GRADE.
- THE SIGNAL CONTRACTOR SHALL DETERMINE IF ANY WORK BY OTHER CONTRACTORS CAN NOT BE COMPLETED UNTIL INSTALLATION OF SIGNAL EQUIPMENT IS COMPLETE. THE SIGNAL CONTRACTOR SHALL NOTIFY OTHER CONTRACTORS OF THIS WORK.
- SEE MAINTENANCE OF TRAFFIC PLANS FOR ADDITIONAL PAVEMENT MARKING DETAILS.

VIDEO
DETECTION
ZONE

REVISIONS	APPROVALS
REBUILD TRAFFIC SIGNAL DUE TO GEOMETRIC IMPROVEMENTS CONTRACT NO. FR4265172 2/23/2005 SRB NML 1/11/2005	TEAM LEADER - TRAFFIC ENGINEERING DESIGN DIVISION
PHASING CHANGE TO SPLIT SIDE STREET SHA NO. BW9961482 3/2004	ASST. TRAFFIC ENGINEERING DESIGN DIVISION
REDLINE REVISION NO. 3 NEW SHEET 2/15/2000	CHIEF TRAFFIC ENGINEERING DESIGN DIVISION
JPL	DIRECTOR, TRAFFIC & SAFETY
REDESIGN SIGNAL FOR REALIGNING OF WB I-70 RAMPS	

MARYLAND DOT - STATE HIGHWAY ADMINISTRATION <i>Office of Traffic & Safety</i> TRAFFIC ENGINEERING DESIGN DIVISION TRAFFIC SIGNALIZATION PLAN MD 355 AND MD 914 (NEW DESIGN RD.)/MONOCACY BLVD.			
DRAWN BY: S. BLOSS	F.A.P. NO. 3929GI	TS NO. 3929GI	SHEET NO. OF
CHECKED BY: N. LEARY	S.H.A. NO.	T.I.M.S. NO. 6 213	
SCALE: 1" = 20'	COUNTY: FREDERICK	LOG MILE:	
DATE: 8-12-99			